

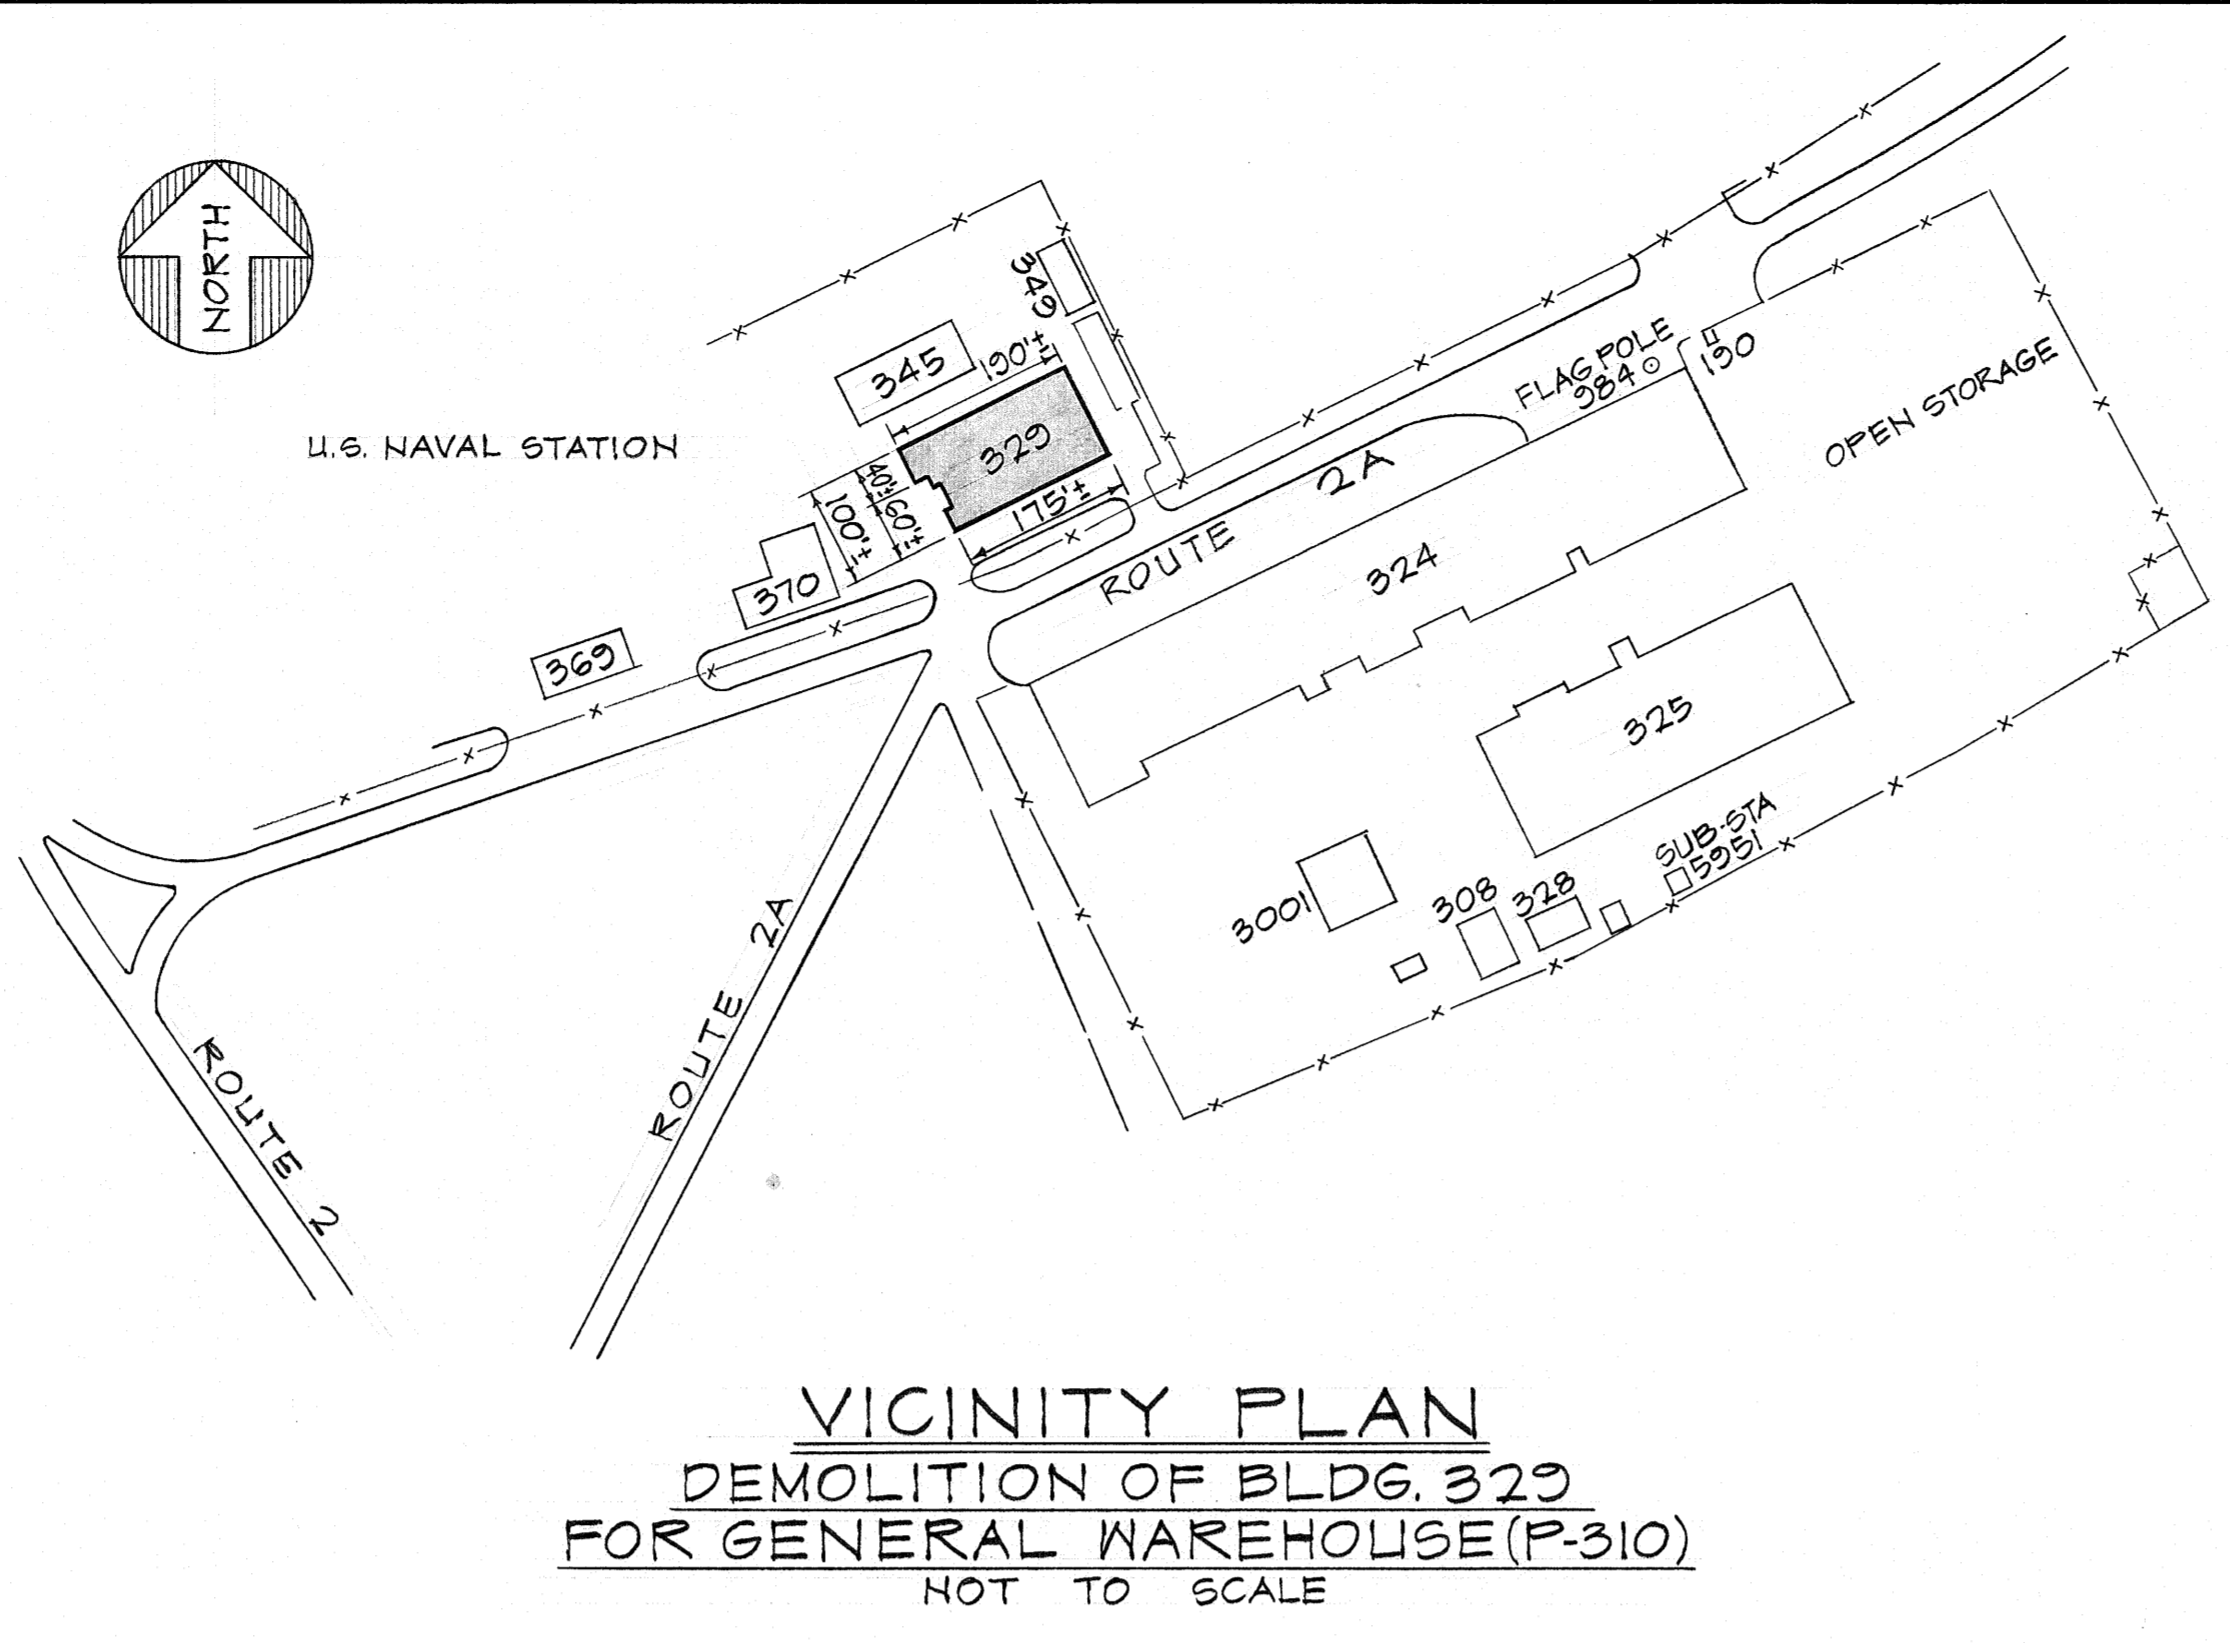
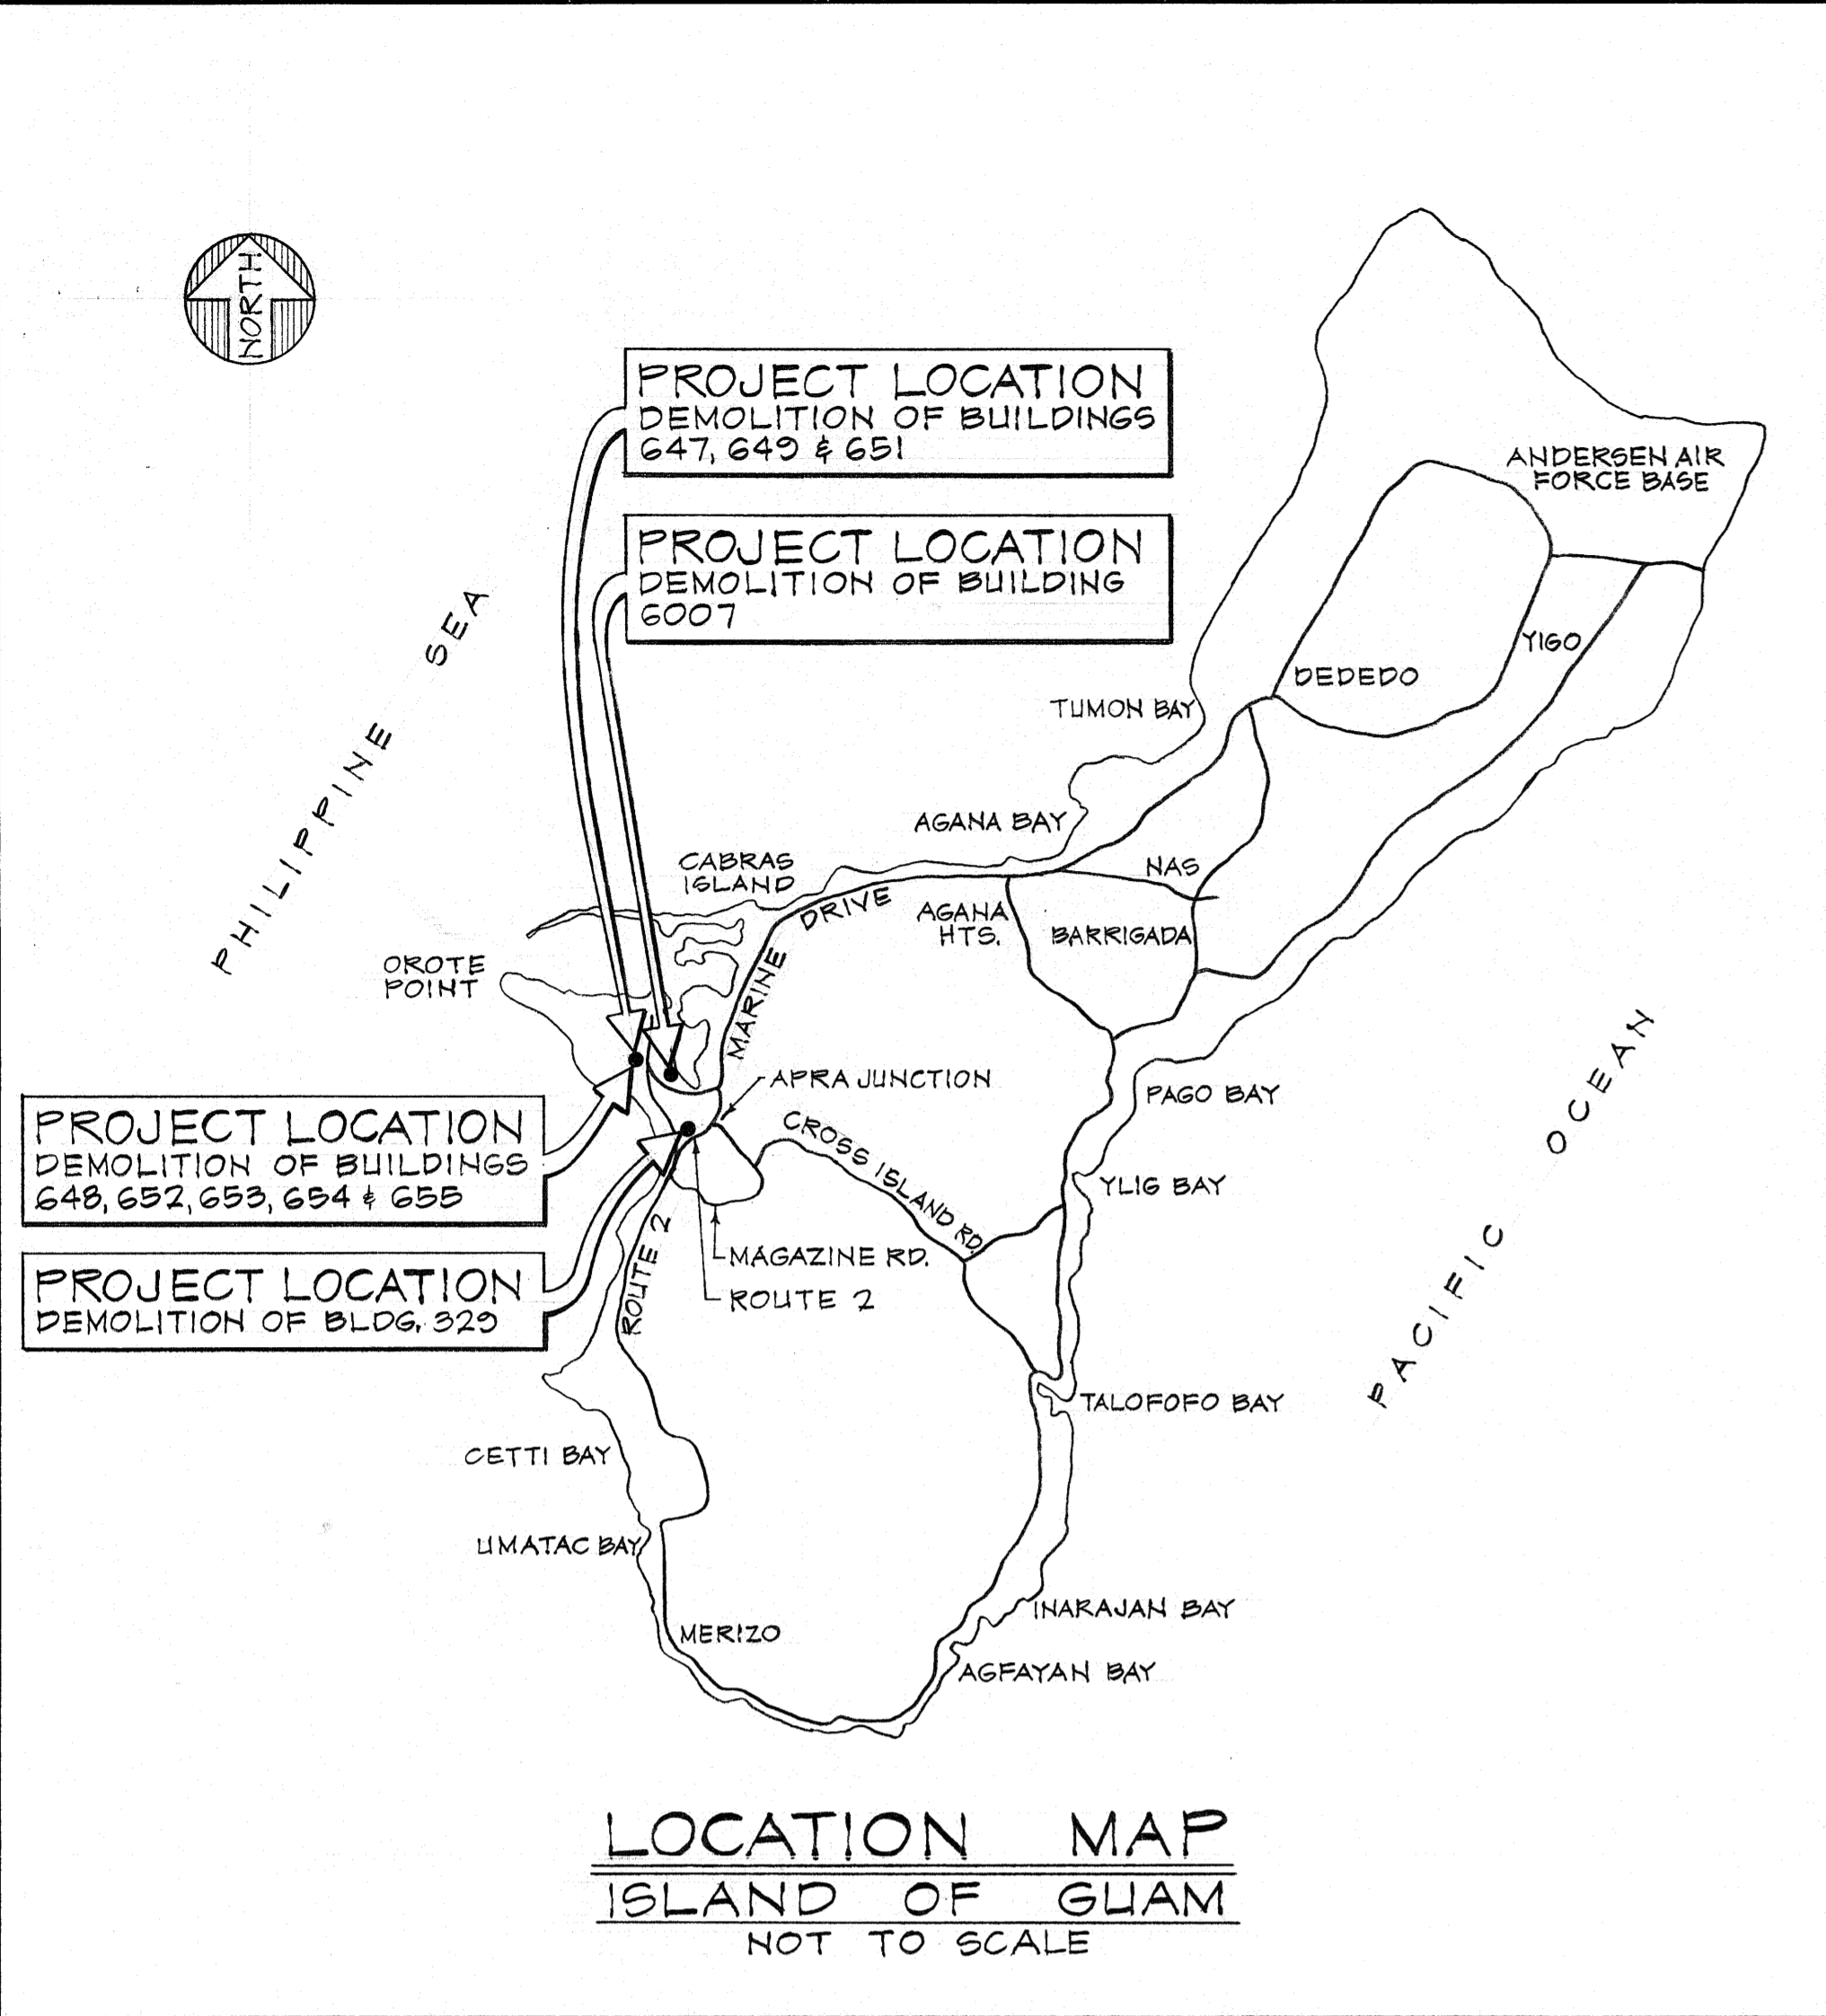


REVISIONS				
LTR.	DESCRIPTION	PREP'D BY	DATE	APPROVED
AS-BUILT		AAYA	31 AUG 60	U

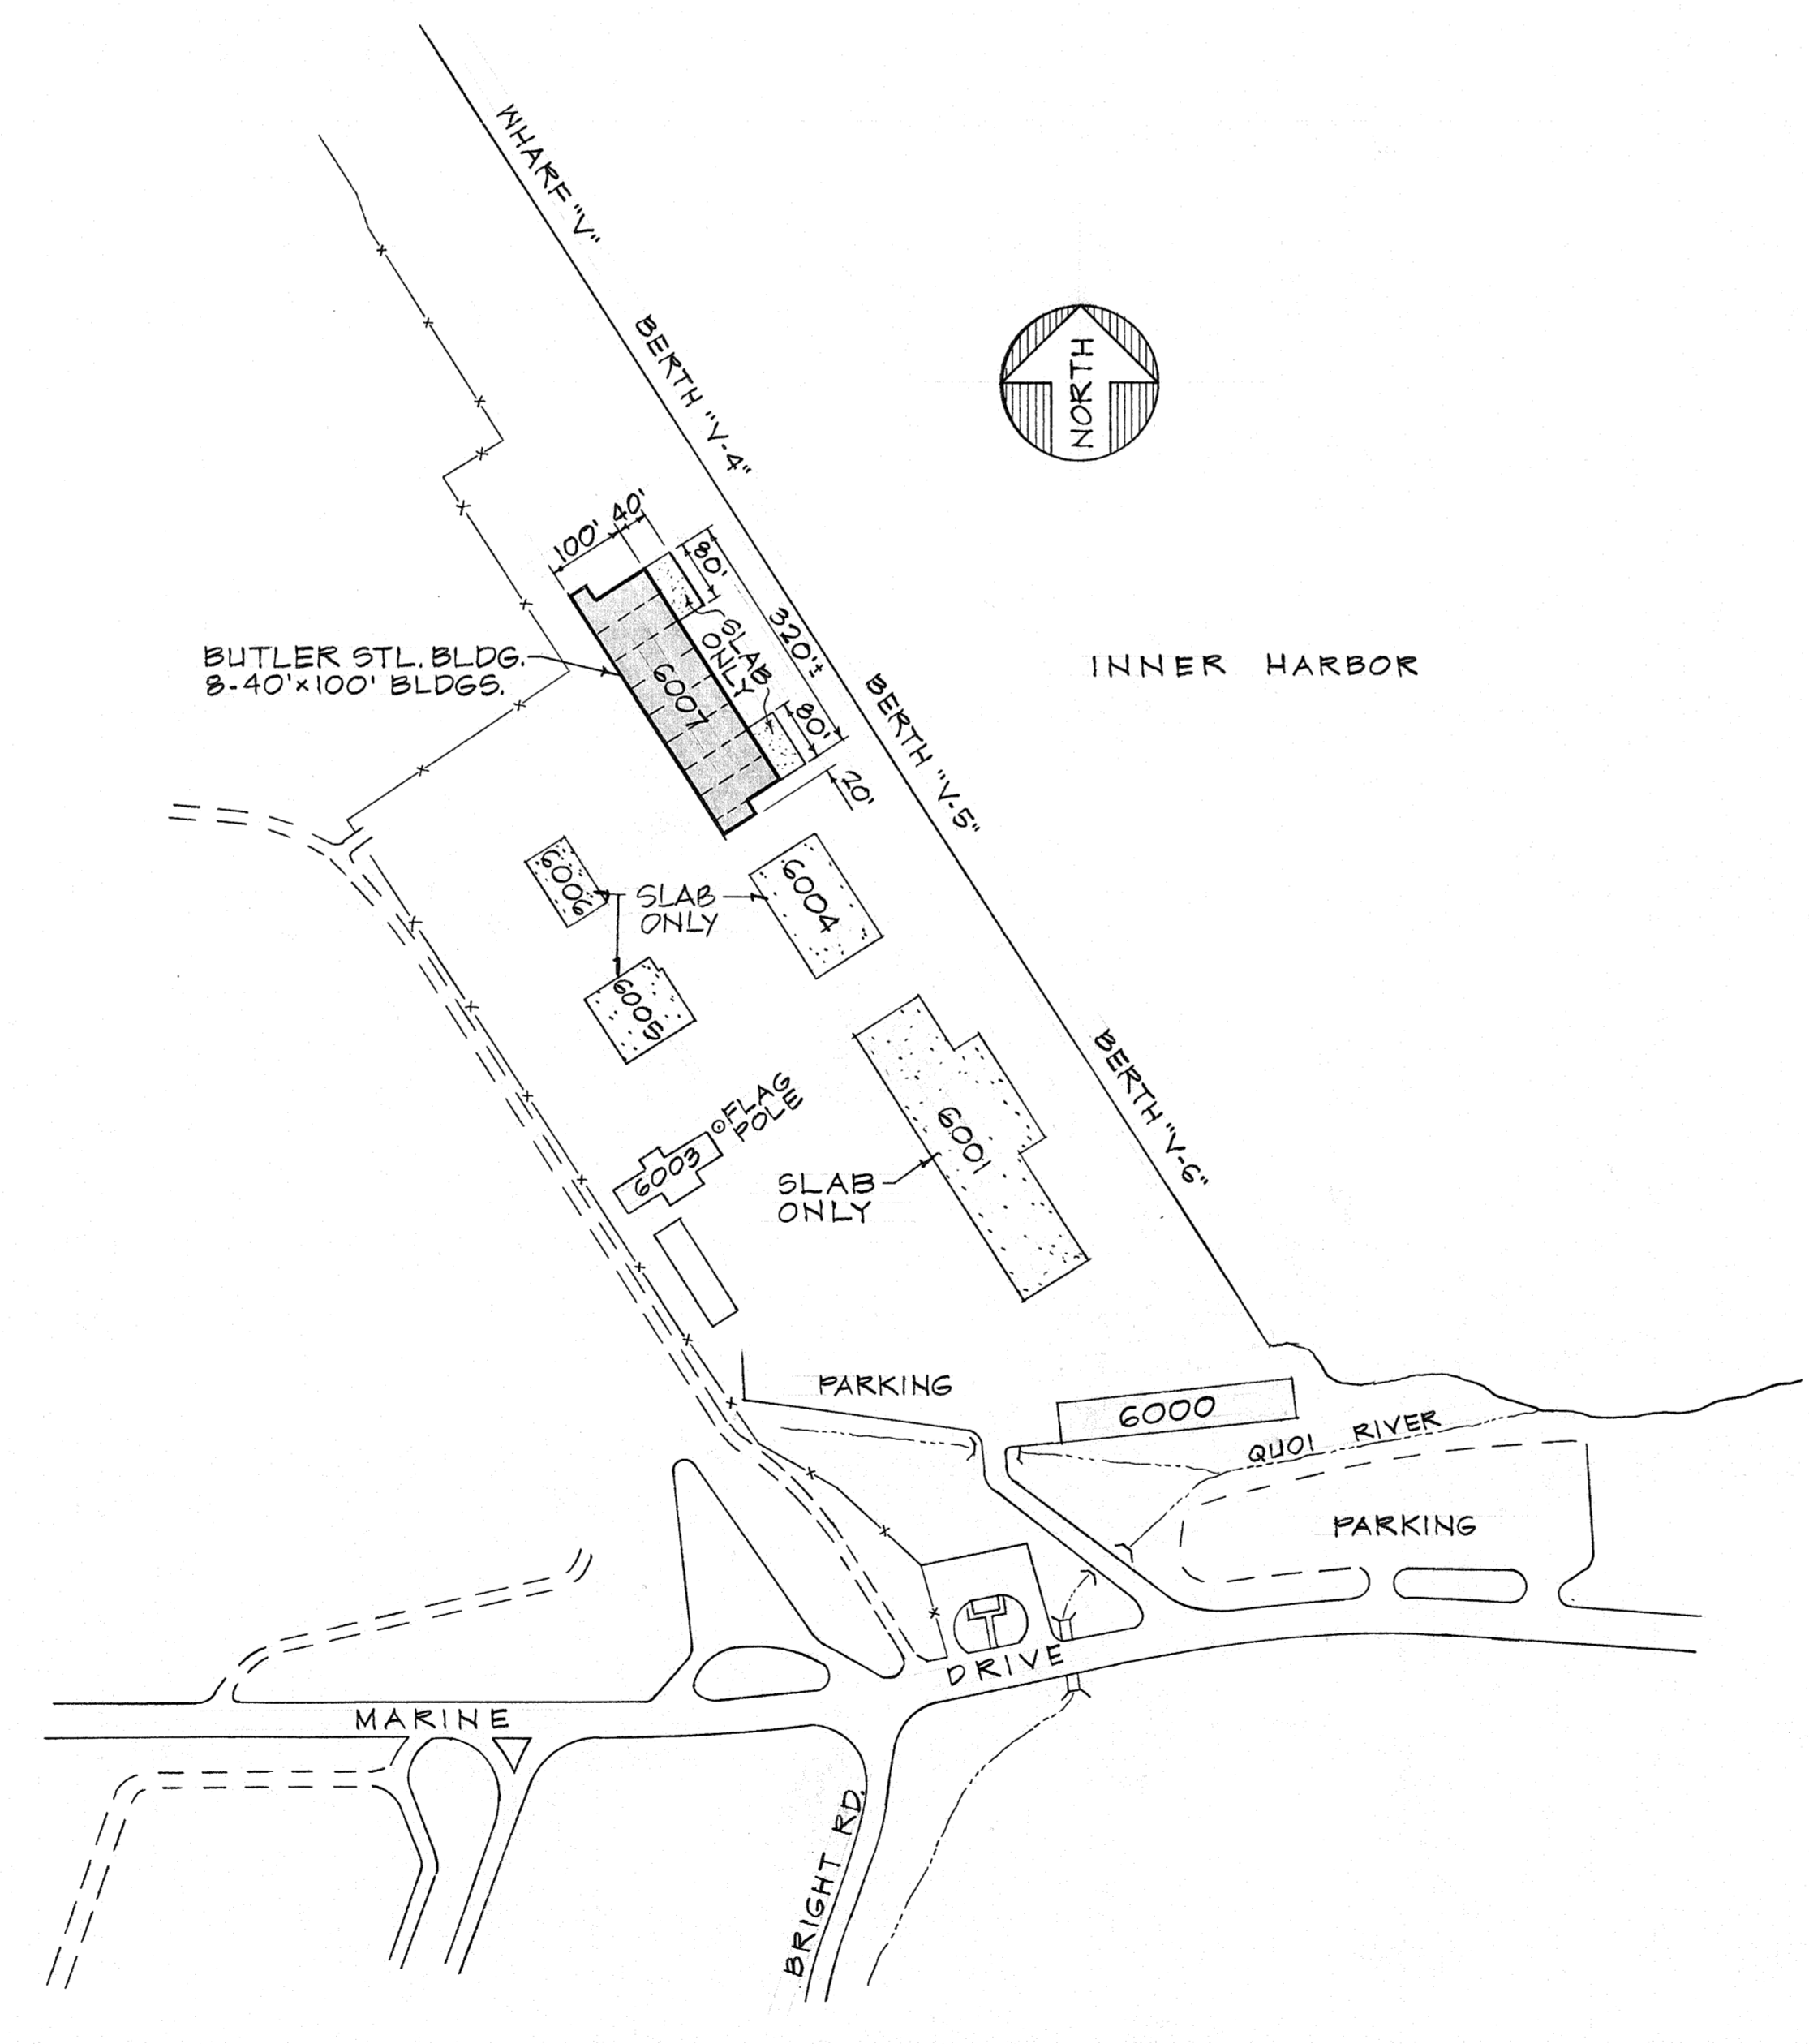

**DEMOLITION NOTES**

1. ALL EXISTING UTILITY LINES SERVING OTHER BUILDINGS IN THE AREA SHALL BE KEPT IN USABLE CONDITION.
2. WATER SERVICE SHALL BE DISCONNECTED AT MAIN OR SHUT-OFF VALVE BY THE GOVERNMENT AND WATER LINES SHALL BE EXPOSED BY CONTRACTOR.
3. SEWER LINES SHALL BE REMOVED TO THE FIRST JOINT BELOW GRADE AND CAPPED.
4. CONTRACTOR SHALL REMOVE ALL CONDUITS AND PIPES WITHIN 12" BELOW GRADE.
5. THE AREA CLEARED SHALL BE GRADED SMOOTH FOR DRAINAGE AND SHALL BE GRASSED BY THE CONTRACTOR, IN AREAS WHERE NO NEW BUILDING IS TO BE CONSTRUCTED UNDER THIS CONTRACT.

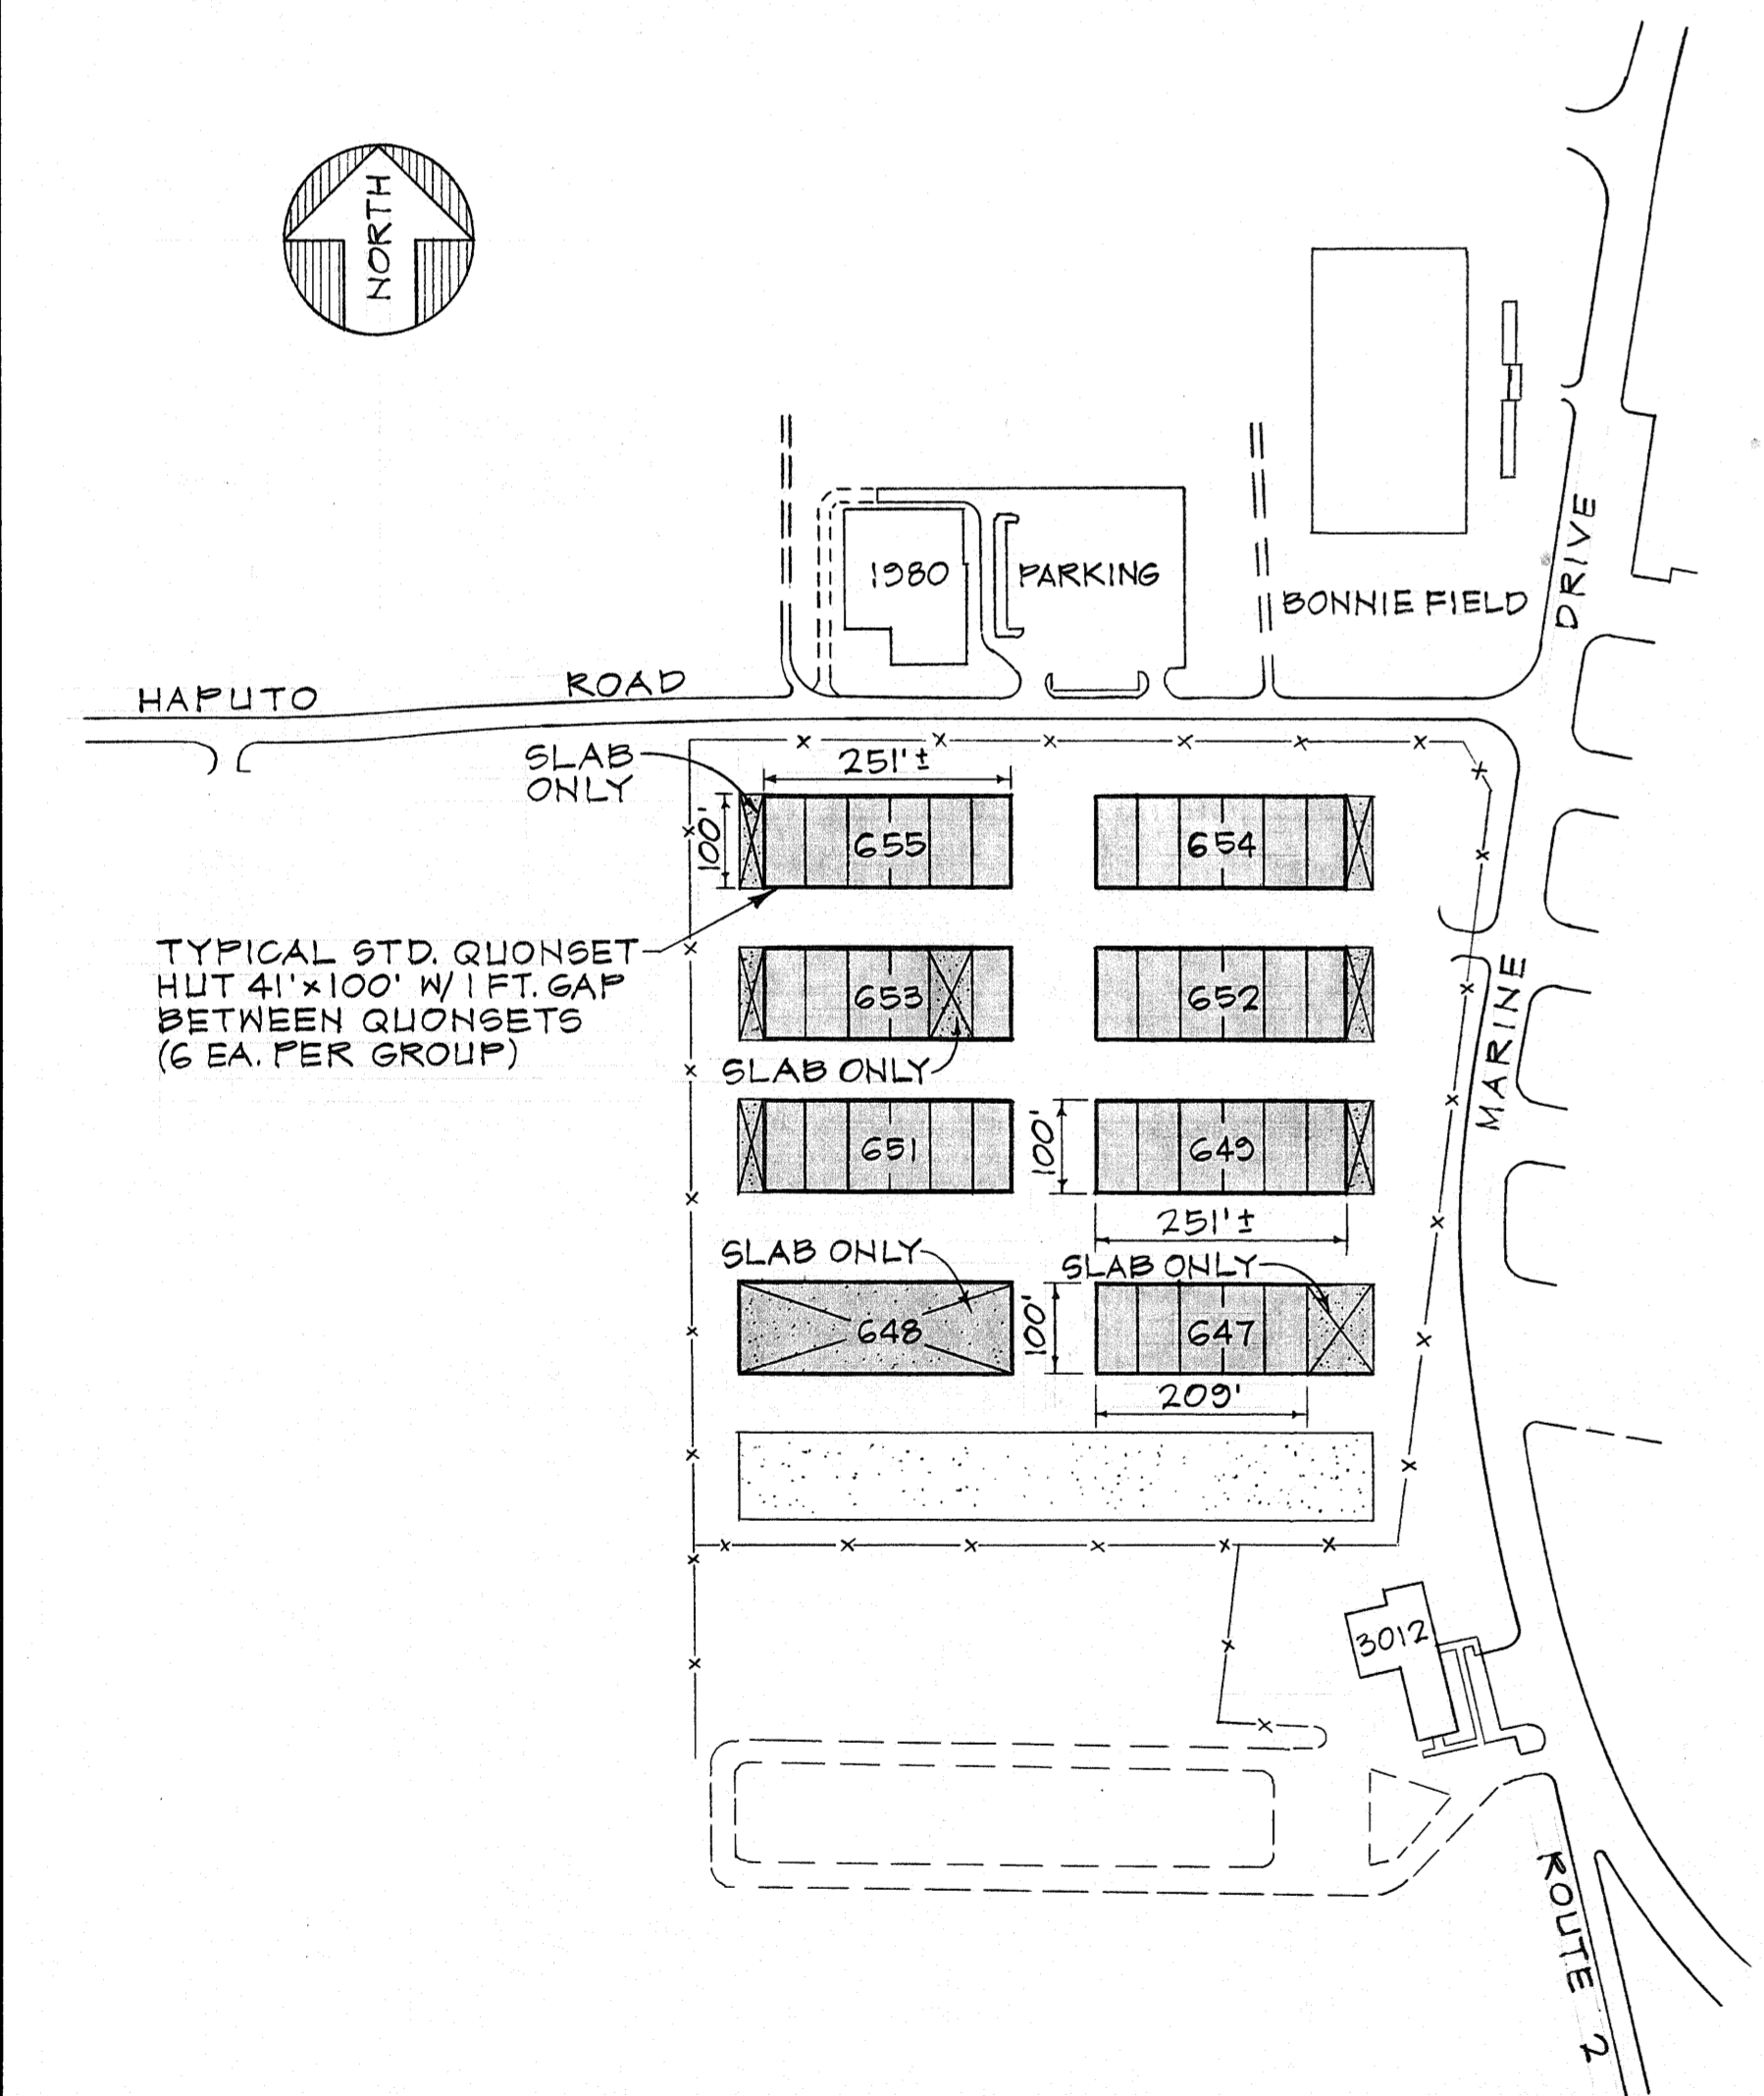

**RECORD DRAWING**  
DATE 31 AUG. 1960


**VICINITY PLAN**  
DEMOLITION OF BLDGS. 648, 652, 653, 654 & 655  
FOR PUBLIC WORKS WAREHOUSE (P-116)  
DEMOLITION OF BLDGS. 647, 649 & 651  
FOR NEX WAREHOUSE ADDITION (P-304)  
NOT TO SCALE

**VICINITY PLAN**  
DEMOLITION OF BLDG. 6007  
FOR NEX WAREHOUSE ADDITION (P-304)  
NOT TO SCALE

**NOTE:**  
CONCRETE SLAB FOR BLDGS. 6007 TO REMAIN  
REMOVE ALL STRUCTURES (CONCRETE, STEEL BOLTS, ETC.) TO SLAB  
LEVEL; CUT-OUT METAL ANCHORS AND CONNECTION TO 2"  
BELOW TOP OF SLAB; EPOXY GROUT ALL CAVITIES IN TOP OF SLAB.

The Contractor will be responsible for coordinating the work among the various trades as necessary to avoid conflicts and to insure the installation of all work within the available space.

IF SHEET IS LESS THAN 28" x 40" IT IS A REDUCED PRINT—SCALE REDUCED ACCORDINGLY

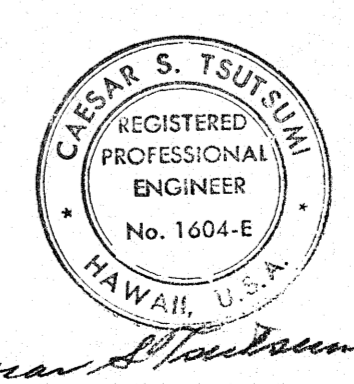

ALFRED A. YEE & ASSOCIATES, INC. 141 KAPOLANI BOULEVARD HONOLULU, HAWAII REG. NO. 22242-76-C-0018		DEPARTMENT OF THE NAVY NAVAL FACILITIES ENGINEERING COMMAND PACIFIC DIVISION MAKALAPA, HAWAII	
DES AN	DR MV	CHK LOA	
SUPV KKK	CH ENG CST		
DESIGNED BY	6/28/60		
FIRM MEMBER TITLE	V. PRES.		
PACDIV SPEC. RVD L. KALAN BR MGR	6/28/60		
DIR. 6/28/60	6/28/60		
APPROVED	DATE	NAVAFAC DRAWING NO.	
FOR COMMANDER NAVFAC	31 AUG 60	7016153	
SCALE 3/8" = 1'-0"	SPEC 41-77-0206	CONSTR CONTR NO N 62166-77-C-0206	SHEET 163 OF 183

**C-29**